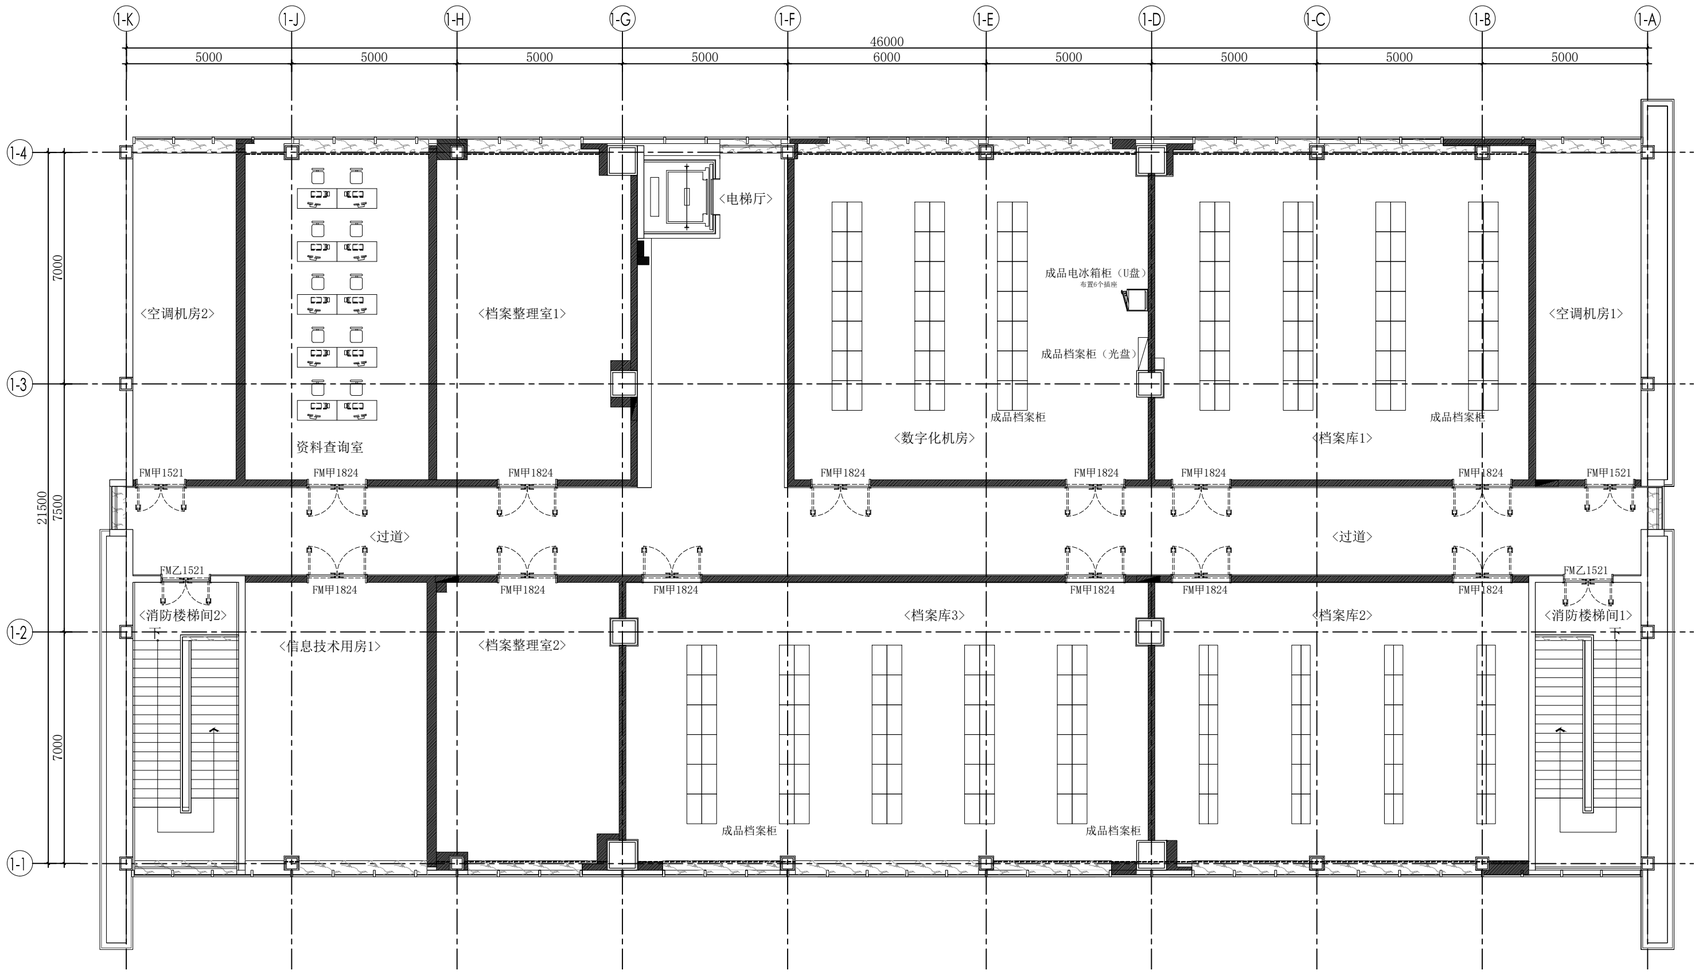


FL 3F功能布置及门索引平面图
FUNSTIONAL LAYOUT PLAN Scale：1：120

门编号		数量
FM甲1521	成品甲级防火门1500*2100	2樘
FMZ乙1521	成品乙级防火门1500*2100	2樘
FM甲1824	成品甲级防火门1800*2400	12樘

注 NOTES

* 本图面尺寸仅供估算或放样的参考,施工时应以现场实际尺寸调整。
* ALL MEASUREMENTS MUST BE CHECKED AT THE SITE-DO NOT SCALE DRAWINGS-FIGURED DIMENSIONS TO BE OBSERVED-READ THIS DRAWING IN CONNECTION WITH GENERAL ARCHITECTURAL PLANS, AND OTHER RELATED DOCUMENTS- THE ARCHITECT TO BE NOTIFIED IMMEDIATELY OF ANY DISCREPANCY FOUND THEREIN.
* 需要建筑师进一步验证,以便符合当地建筑规范的要求.
* FOR FURTHER VERIFICATION BY ARCHITECTS TO COMPLY WITH LOCAL CODES & REGULATIONS.

备注：NOTES

HUANAN DECORATE

深圳市华南装饰集团股份有限公司
SHENZHEN HUANAN DECORATE GROUP CO,. LTD.
中华人民共和国建筑施工一级企业 中华人民共和国建筑设计甲级企业

建设单位 CLIENT
淮安市清浦城市改造建设投资开发有限公司

项目名称 PROJECT TITLE
清江浦区档案馆加固改造EPC总承包工程

索引平面 KEY PLAN

会签栏 SIGNATURE

设计总负责 DESIGN DIRECTOR	牛洪林	
设 计 DESIGN BY	李瑞云	
绘 图 DRAWN BY	李瑞云	
审 核 APPROVED BY	周峰波	

项目阶段: PROJECT STAGE 竣工图

图纸名称: DRAWING TITLE
3F功能布置及门索引平面图

图 号: DWG NO 2F-PL-01
比 例: SCALE 1:120 @ A2
日 期: DATE 2021.06
业务号: